

South Carolina Department of Health and Environmental Control
Office of Ocean and Coastal Resource Management
927 Shine Avenue
Myrtle Beach, SC 29577

April 4, 2013

Amendment Permit Application Public Notice

J. P. Michenon, OCRM-09-555-S

The Department has received an application for a permit for the alteration of a critical area. The application was submitted pursuant to the Coastal Zone Management Act (Act 123) of 1977 South Carolina General Assembly. The application in brief, is described as follows:

Applicant: J. P. Michenon


Location: On and adjacent to Carson Creek at 25 Gasparilla Circle, Murrells Inlet, Georgetown County, South Carolina.
TMS: 41-0106-036-19-00

Work: The permittee has requested an after-the-fact amendment to the issued permit. Specifically, the applicant seeks to keep the 4.8' x 166' walkway, with handrails, leading to a covered 8.8' x 9.1' pierhead. Ebbside of the pierhead, a ramp landing will provide access to a 3.9' x 16' ramp that will lead to an 8.2' x 12.9' floating dock. The amendment is for after-the-fact authorization at a private, recreational dock.

This public notice is being distributed to all known interested persons and agencies to assist in developing facts on which a decision by the Department can be based. Comments concerning the proposed work must be submitted in writing, setting forth sufficient detail to furnish a clear understanding of the reasons for support or opposition.

Comments regarding this application must be received by the Department on or before **April 14, 2013**. For more information, please contact **Chris Stout** at **843-238-4528** or via email at **stoutcm@dhec.sc.gov**.

Note: Plans depicting the proposed work are available and will be provided upon receipt of a written request or may be viewed on the Department website at **www.scdhec.gov/environment/ocrm/public_notice.htm**

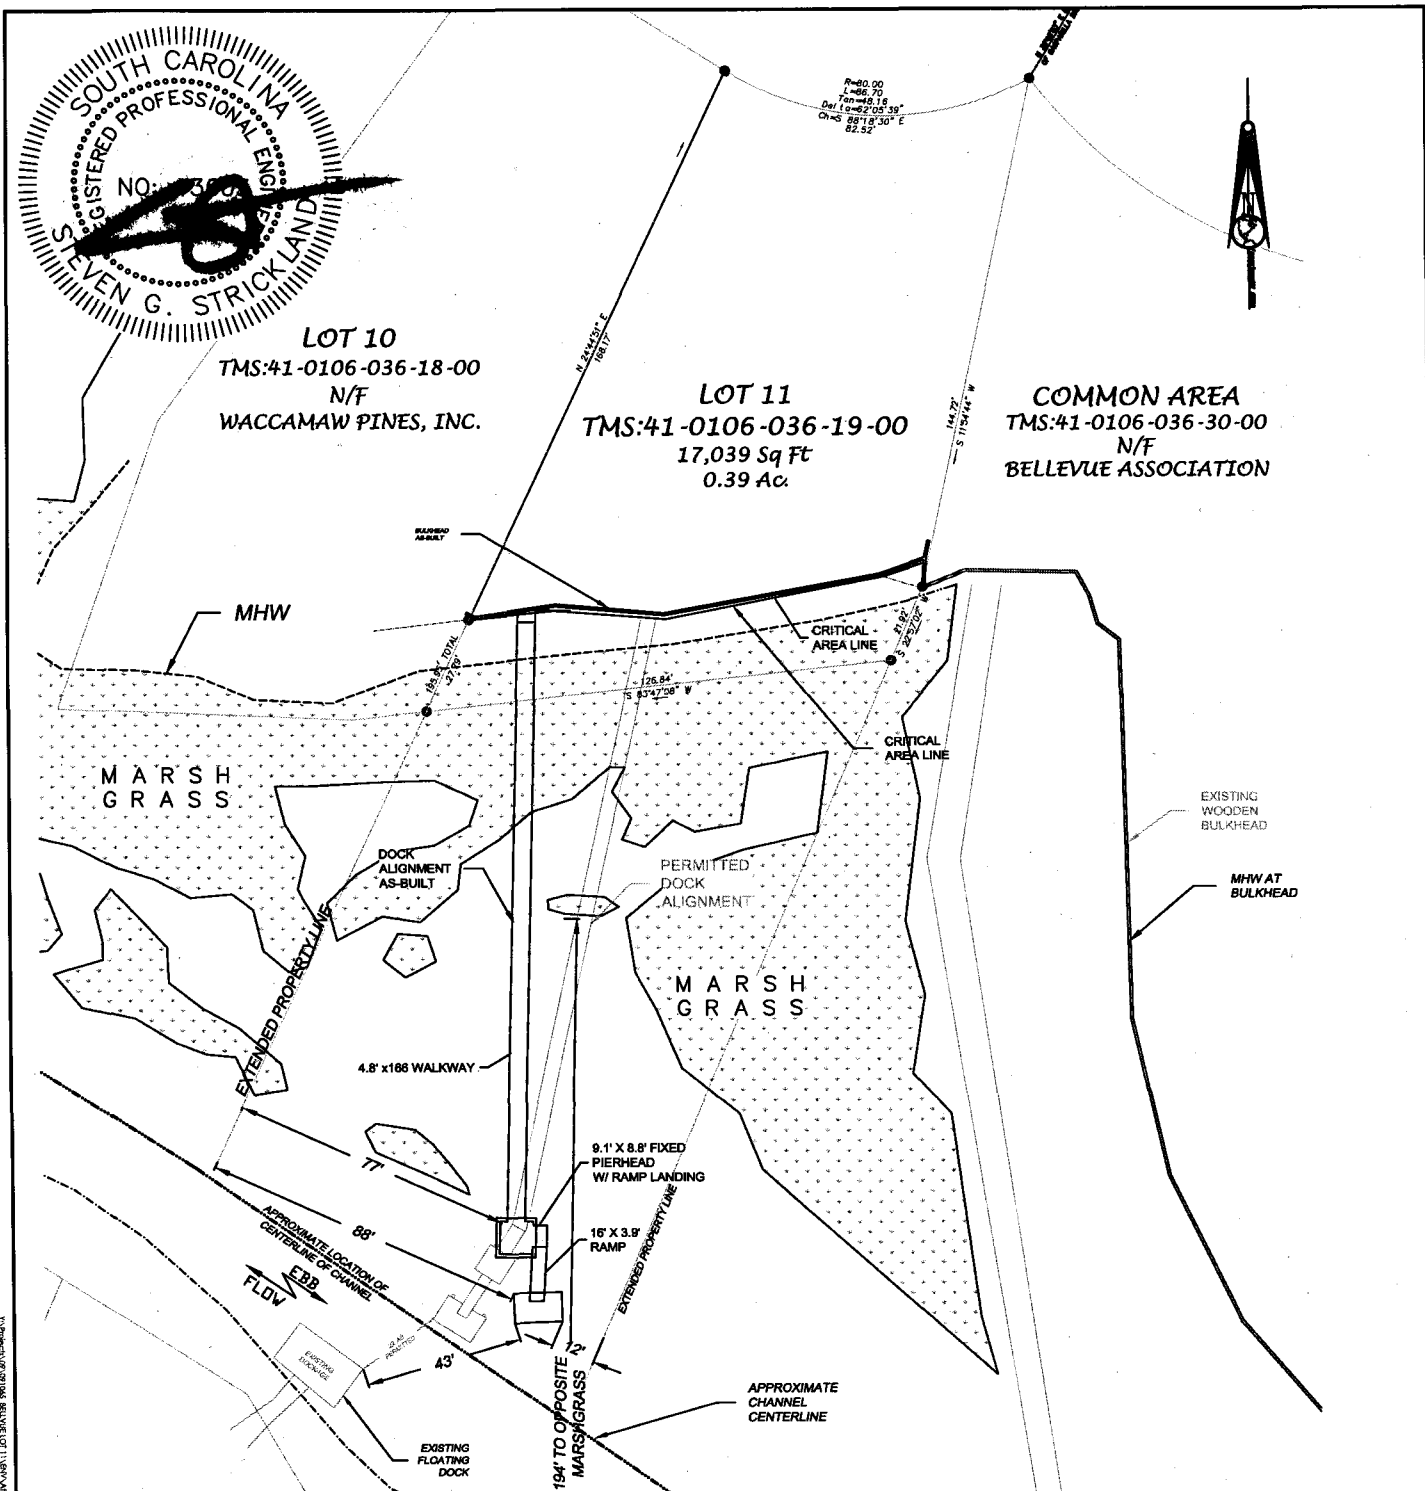

CRITICAL AREA LINE CERTIFIED
BY CHRIS STOUT ON 11/5/2009

AS-BUILT DRAWING OVERALL SITE

PROJECT NAME:
BELLE VUE LOT 11
CRITICAL AREA PERMIT OCRM-09-555-S AMENDMENT

APPLICANT:
J.P. MICHENON
25 GASPARILLA CIRCLE
MURRELLS INLET, SC 29576-4814
843-215-0757

A-T-F - Amendment
OCR-09-555-S

AGENT:
EARTHWORKS
11655 HIGHWAY 707
MURRELLS INLET, SC 29576
phone-843.651.7900
fax-843.651.7903
www.earthworksgroup.com



SCALE:
1" = 50'



LAT/LONG: 33°34'10.06"N
by 79°01'12.14"W


USGS QUAD NAME:
BROOKGREEN

REVISION SCHEDULE:

NO DATE BY

SHEET: 1

Disclaimer: The EARTHWORKS Group is hereby known as EW Inc. The User agrees not to use this document, in whole or part, for any purpose or project other than the project, which is the subject of this Agreement. User agrees to waive all claims against EW Inc. resulting in any way from unauthorized changes or reuse of this document by anyone other than EW Inc. In addition, User agrees to the fullest extent permitted by law, to indemnify and hold EW Inc. harmless from any damage, liability or cost, including reasonable attorney's fees and costs of defense arising from any changes made by anyone other than EW Inc. or from any reuse of the document without the prior written consent of EW Inc. This item may not be copied in whole or in part without the express written consent from EW Inc. The information on this map has been compiled from various sources. The information is not guaranteed, expressly or implied. In certain situations, the map has been prepared without the benefit of a Threatened and Endangered Species Study, Phase I Site Assessment, Wetlands Delineation, or Archeological Assessment. The results of these investigations could materially alter the map as shown.

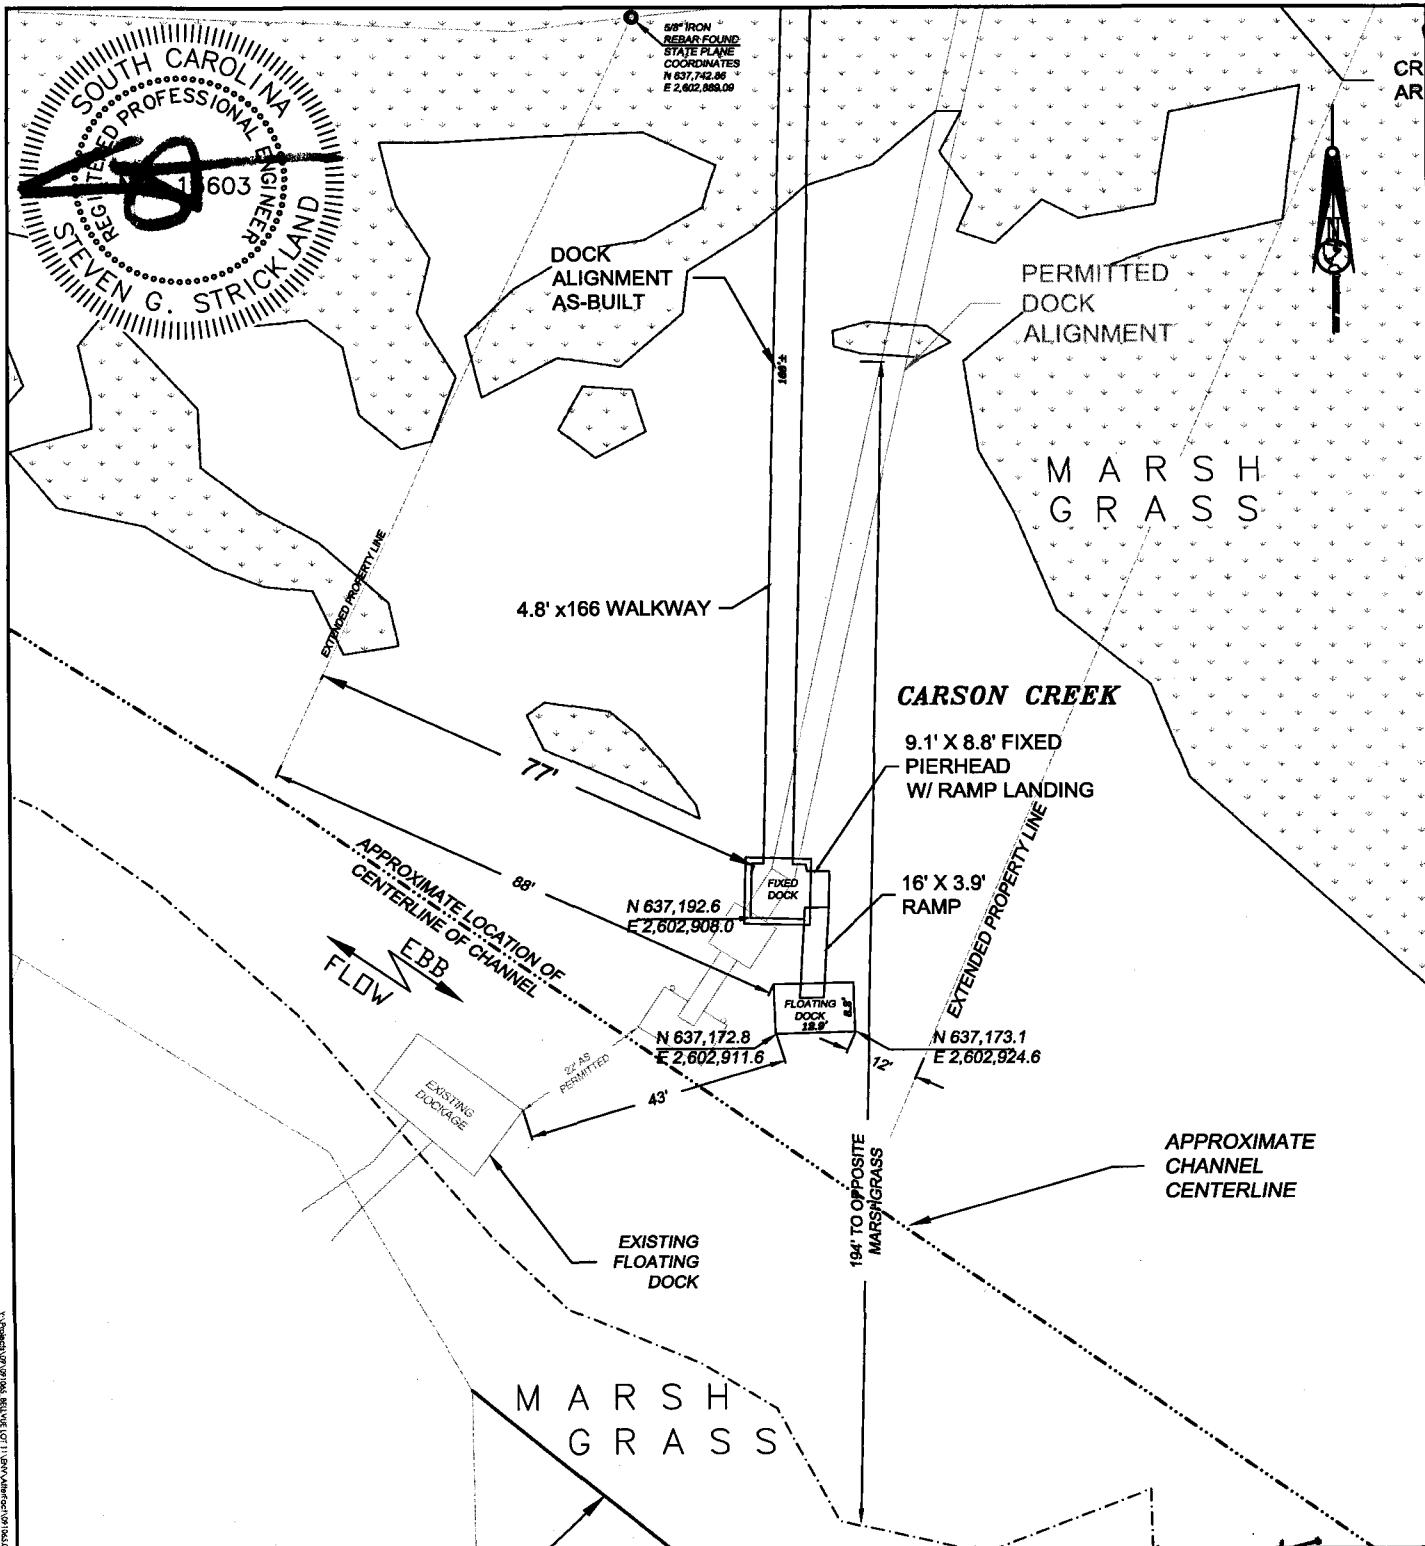

SHEET TITLE:
AS-BUILT DRAWING DOCK DETAIL

APPLICANT:
J.P. MICHENON
25 GASPARILLA CIRCLE
MURRELLS INLET, SC 29576-4814
843-215-0757

A-T-F - Amendment
OCRM-09-555-S

PROJECT NAME:
BELLE VUE LOT 11
CRITICAL AREA PERMIT OCRM-09-555-S AMENDMENT

PROJECT LOCATION:
25 GASPARILLA CIR. MURRELLS INLET
GEORGETOWN CO. SOUTH CAROLINA

DOCUMENT #:

DATE: 3/27/13
TEG P/N: 091065.001
AUTHOR: SANNESE

AGENT:
EARTHWORKS
planning and design consultants
11655 HIGHWAY 707
MURRELLS INLET, SC 29576
phone - 843.651.7900
fax - 843.651.7903
www.earthworksgroup.com



SCALE:
1" =
30' XREF



LAT/LONG: 33°34'10.06"N
by 79°01'12.14"W
USGS QUAD NAME:
BROOKGREEN
SHEET: 3

REVISION SCHEDULE:

NO	DATE	BY

Disclaimer: The EARTHWORKS Group is hereby known as EW Inc. The User agrees not to use this document, in whole or in part, for any purpose or project other than the project, which is the subject of this Agreement. User agrees to waive all claims against EW Inc. resulting in any way from unauthorized changes or reuse of this document by anyone other than EW Inc. In addition, User agrees to the fullest extent permitted by law, to indemnify and hold EW Inc. harmless from any damage, liability or cost, including reasonable attorney's fees and costs of defense arising from any changes made by anyone other than EW Inc. or from any reuse of the document without the prior written consent of EW Inc. This item may not be copied in whole or in part without the express written consent from EW Inc. The information on this Map has been compiled from various sources. The information is not guaranteed, expressly or implied. In certain situations, the map has been prepared without the benefit of a Threatened and Endangered Species Study, Phase I Site Assessment, Wetlands Delineation, or Archeological Assessment. The results of these investigations could materially alter the map as shown.



LOT 10
TMS:41-0106-036-18-00
N/F
WACCAMAW PINES, INC.

LOT 11
TMS:41-0106-036-19-00
17,039 Sq Ft
0.39 Acs

MULTI-STORY CONCRETE
WALLED DWELLING
UNDER CONSTRUCTION
AT TIME OF SURVEY

P.K. NAIL
FOUND

WOODEN BULKHEAD

CRITICAL
AREA LINE

5/8" IRON
REBAR FOUND
STATE PLANE
COORDINATES
N 637,742.86
E 2,602,889.09

126.84'
S 83°47'08" W

5/8" IRON
REBAR FOUND

CRITICAL AREA LINE CERTIFIED
BY CHRIS STOUT ON 11/5/2009

SHEET TITLE:

**AS-BUILT DRAWING
BULKHEAD DETAIL**

APPLICANT:

J.P. MICHENON
25 GASPARILLA CIRCLE
MURRELLS INLET, SC 29576-4814
843-215-0757

ATF Amendment
OCRM-09-555-S

PROJECT NAME:

BELLE VUE LOT 11
CRITICAL AREA PERMIT OCRM-09-555-S AMENDMENT

PROJECT LOCATION:

25 GASPARILLA CIR. MURRELLS INLET
GEORGETOWN CO. SOUTH CAROLINA

DOCUMENT #:

DATE: 3/27/13

TEG P/N: 091065.001

AUTHOR: SANNESSE

AGENT:

EARTHWORKS
planning and design consultants

11655 HIGHWAY 707
MURRELLS INLET, SC 29576
phone - 843.651.7900
fax - 843.651.7903
www.earthworksgroup.com



SCALE:

1" = 20'



LAT/LONG: 33°34'10.06"N

by 79°01'12.14"W



USGS QUAD NAME:
BROOKGREEN

SHEET: 2

REVISION SCHEDULE:

NO DATE BY

Disclaimer: The EARTHWORKS Group is hereby known as EW Inc. The User agrees not to use this document, in whole or part, for any purpose or project other than the project, which is the subject of this Agreement. User agrees to waive all claims against EW Inc. resulting in any way from unauthorized changes or reuse of this document by anyone other than EW Inc. In addition, User agrees to the fullest extent permitted by law, to indemnify and hold EW Inc. harmless from any damage, liability or cost, including reasonable attorney's fees and costs of defense arising from any changes made by anyone other than EW Inc. or from any reuse of the document without the prior written consent of EW Inc. This item may not be copied in whole or in part without the express written consent from EW Inc. The information on this map has been compiled from various sources. The information is not guaranteed, expressly or implied. In certain situations, this map has been prepared without the benefit of a Threatened and Endangered Species Study, Phase I Site Assessment, Wetlands Delineation, or Archeological Assessment. The results of these investigations could materially alter the map as shown.

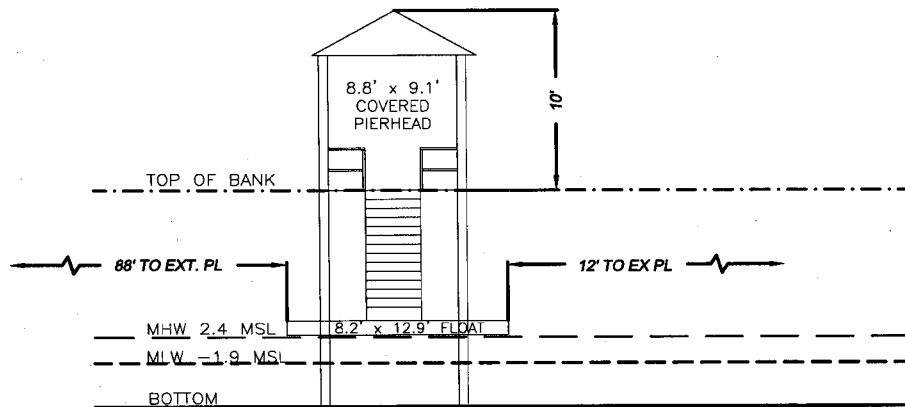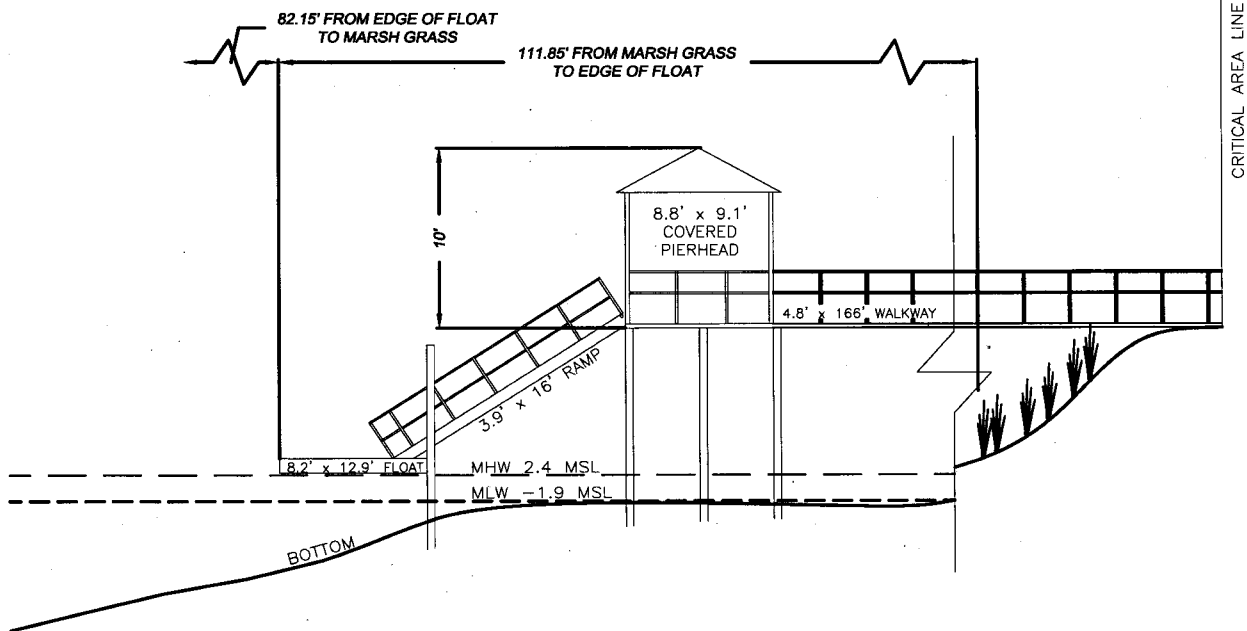

SHEET TITLE:
AS-BUILT DRAWING
DOCK DETAIL

APPLICANT:
J.P. MICHENON
25 GASPARILLA CIRCLE
MURRELLS INLET, SC 29576-4814
843-215-0757

ATF Amendment
OCRM-09-555-S

PROJECT NAME:
BELLE VUE LOT 11
CRITICAL AREA PERMIT OCRM-09-555-S AMENDMENT

PROJECT LOCATION:
25 GASPARILLA CIR. MURRELLS INLET
GEORGETOWN CO. SOUTH CAROLINA


DOCUMENT #:

DATE: 3/27/13
TEG P/N: 091065.001
AUTHOR: SANNESE

AGENT:
EARTHWORKS
planning and design consultants
11655 HIGHWAY 707
MURRELLS INLET, SC 29576
phone-843.651.7900
fax-843.651.7903
www.earthworksgroup.com



SCALE:
1" = 10'

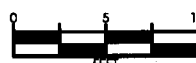

LAT/LONG: 33°34'10.06"N
by 79°01'12.14"W
USGS QUAD NAME:
BROOKGREEN
SHEET: 4

REVISION SCHEDULE:		
NO	DATE	BY

Disclaimer: The EARTHWORKS Group is hereby known as EW Inc. The User agrees not to use this document, in whole or part, for any purpose or project other than the project, which is the subject of this Agreement. User agrees to waive all claims against EW Inc. resulting in any way from unauthorized changes or reuse of this document by anyone other than EW Inc. In addition, User agrees to the fullest extent permitted by law, to indemnify and hold EW Inc. harmless from any damage, liability or cost, including reasonable attorney's fees and costs of defense arising from any changes made by anyone other than EW Inc. or from any reuse of the document without the prior written consent of EW Inc. This item may not be copied in whole or in part without the express written consent from EW Inc. The information on this Map has been compiled from various sources. This information is not guaranteed, expressly or implied. In certain situations, the map has been prepared without the benefit of a Threatened and Endangered Species Study, Phase I Site Assessment, Wetlands Delineation, or Archeological Assessment. The results of these investigations could materially alter the map as shown.